


AS-BUILT PLAN
CARLISLE, MASSACHUSETTS

1" = 60' MAY 22, 2000

SNELLING & HAMEL ASSOCIATES
PROFESSIONAL LAND SURVEYORS
10 LEWIS STREET P.O. BOX 102
LINCOLN, MASSACHUSETTS 01773

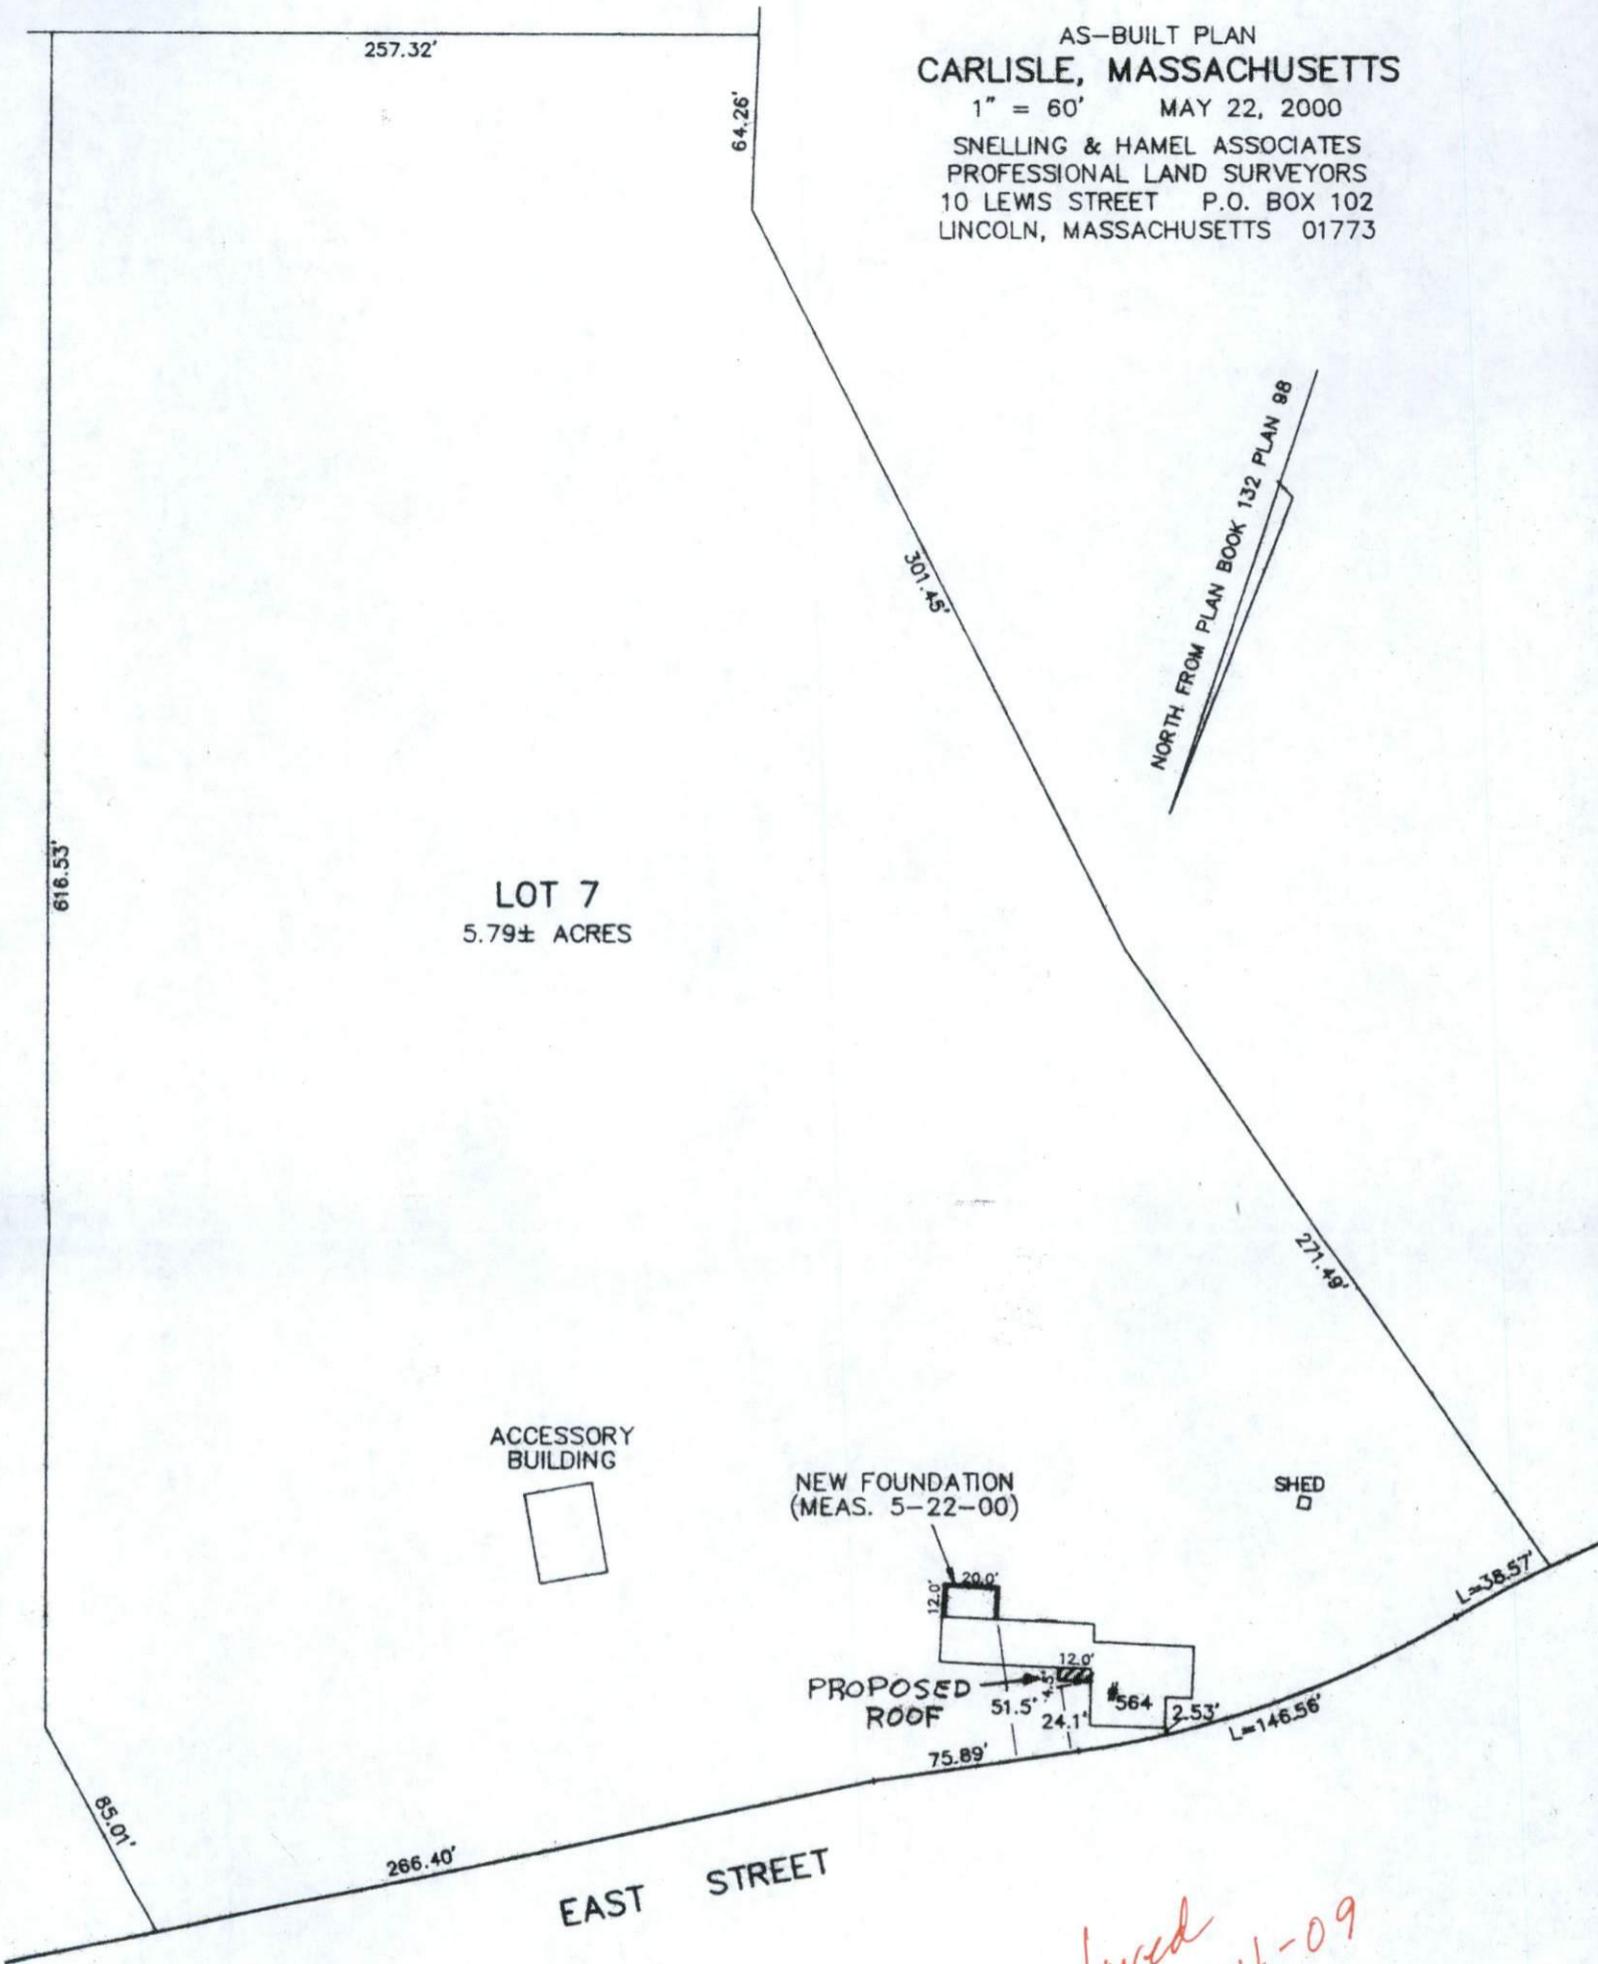

*Fixed
2-24-09*

REFERENCES:

- PLAN DATED JUNE 12, 1980; BOOK OF PLANS 132 PLAN 98
- DEED TO MADGE H. AND RICHARD D. NICKERSON, RECORD BOOK 3480 PAGE 112
- THE DWELLING IS SUBJECT TO A BOARD OF APPEALS DECISION BECAUSE OF IT'S NON-CONFORMING STATUS (CASE #9920)

I HEREBY STATE THAT THE LOCATION OF THE STRUCTURES SHOWN HEREON IS THE RESULT OF AN INSTRUMENT SURVEY DATED MAY 22, 2000

John R. Hamel
JOHN R. HAMEL
PROFESSIONAL
LAND SURVEYORS



5/23/2000
DATE:

*B6138
SWY 205V*