


LEGEND:


- N/F NOW OR FORMERLY
- FF FIRST FLOOR
- TC TOP OF CONCRETE
- OHV OVERHEAD WIRES
- TREE
- ~ TREE LINE
- UP UTILITY POLE
- GG+ GAS GATE
- G GAS SERVICE (BURIED)
- WG+ WATER GATE
- W WATER SERVICE (BURIED)
- DMH DRAIN MANHOLE
- SMH SEWER MANHOLE
- CB CATCH BASIN
- DI DROP INLET
- D SUB-SURFACE DRAIN LINE
- UGW UNDERGROUND WIRES
- S SUB-SURFACE SEWER LINE
- SD SUBDRAIN LINE
- EXISTING CONTOUR
- - - EXISTING CONTOUR
- ☆ LIGHTPOLE
- △ WETLAND FLAG
- 99X9 SPOT ELEVATION
- ○ ○ ○ ○ STONE WALL
- EDGE OF PAVEMENT

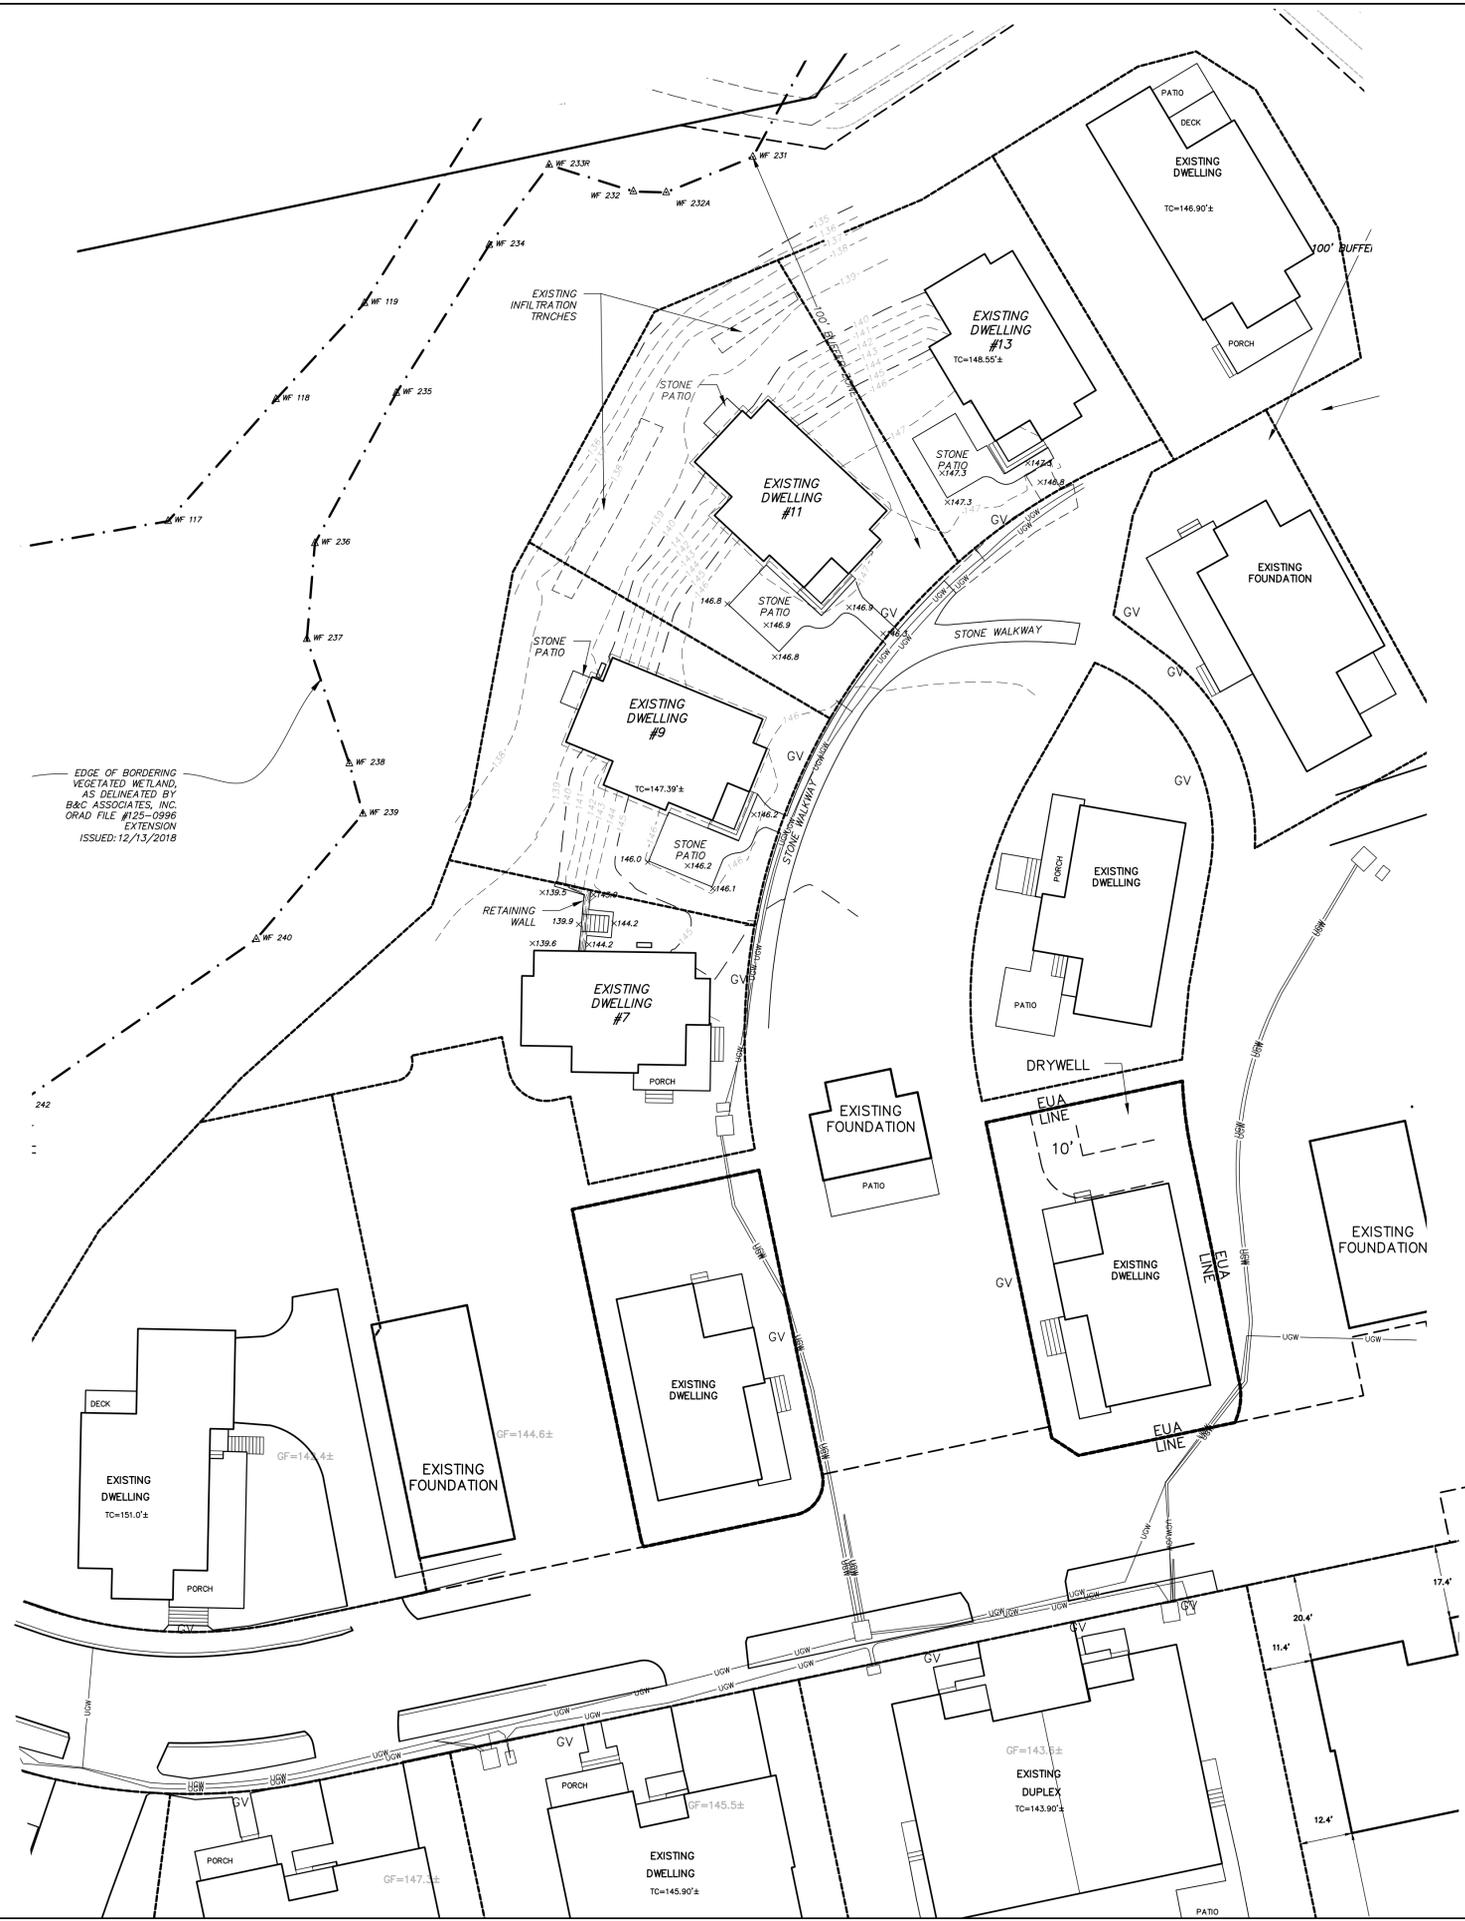

PROGRESS PRINT
DATE: 11/5/25

AS BUILT GRADING PLAN
 UNITS 7-13
 IN
CARLISLE, MASSACHUSETTS
 (MIDDLESEX COUNTY)
 FOR: NOW COMMUNITIES LLC
 SCALE: 1"=20' NOVEMBER 4, 2025

STAMSKI AND McNARY, INC.
 1000 MAIN STREET ACTON, MASSACHUSETTS
 ENGINEERING - PLANNING - SURVEYING

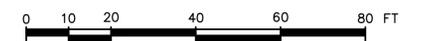

(5383A.SITE.GRADING.AS BUILT.dwg) Kay's Walk SM-5383A

DATUM

NAVD OF 1988
 ADD 0.82' TO CONVERT TO NGVD OF 1929